




Verbeck Drive

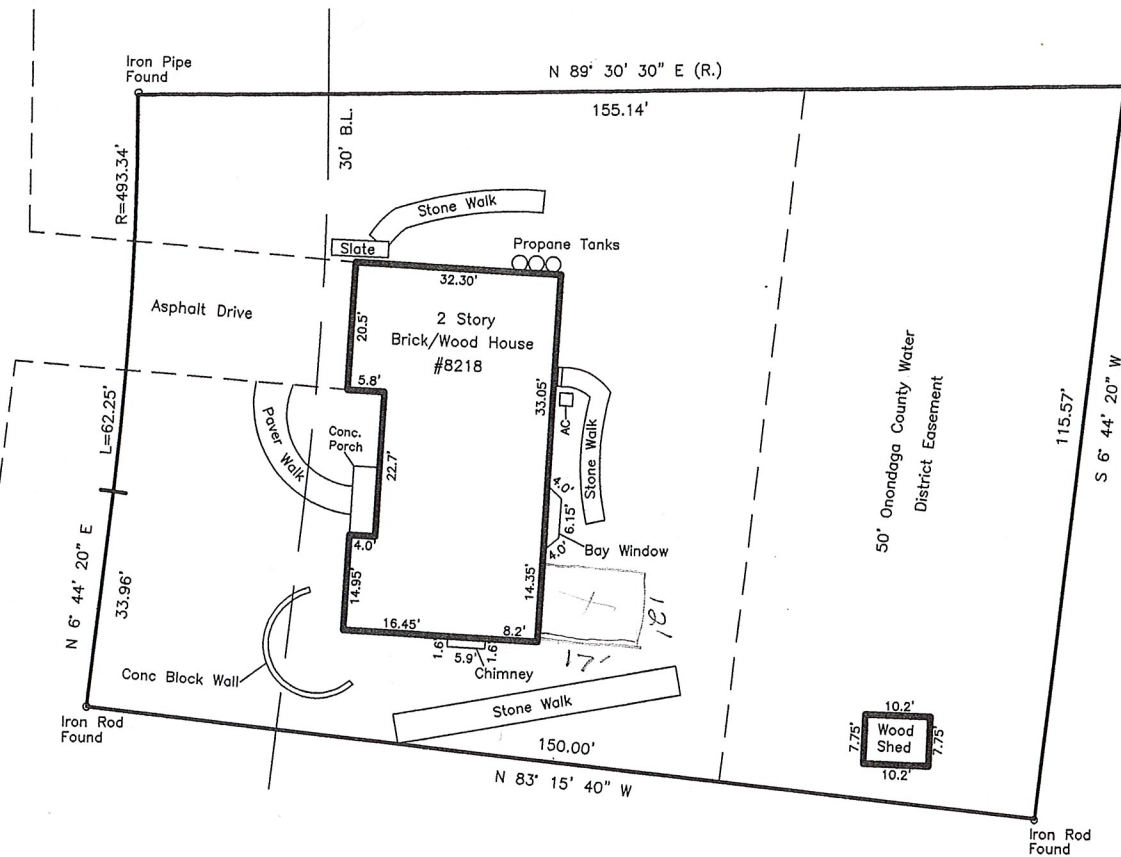

**Lot 8 Sec A Verbeck  
Town Of Manlius  
Onondaga County**

Scale 1" = 30'  
March 29, 2023

F:/J234072/Base Plan/dwg/Lot 8 Sec A Verbeck



**D. W. HANNIG L.S., P.C.**

SURVEYORS - PLANNERS - CONSULTANTS  
THE MARKET PLACE, BUILDING #1  
MANLIUS, NEW YORK 13104  
PHONE: (315) 682-5225 - FAX: (315) 682-7774

In my professional opinion, and based on my observations and/or scope of service, I hereby certify this map was made from an actual survey on 3/29/23, and this map is correct.

This certification is void unless signed in RED ink.

DAVID WILLIAM HANNIG, P.L.S., - N.Y.S. LIC. NO. 47411

